

REV. NO.	DESCRIPTION	DATE	BY
1	REV. TP 21/AM APPLICABLE TO AE 21 (FAST) CONVERSION ONLY.		
2	THIS PLAN HAS BEEN CHECKED AGAINST ACTUAL CONDITIONS BY PHYSICAL SURVEY AND HAS BEEN UPDATED TO INCLUDE ALL MODIFICATIONS AND SHIP ALTERS DURING R.O.H. AT COASTAL DRY DOCK AND REPAIR CORP., 1979.		

AE 21	BETHLEHEM STEEL CO. SHIP BUILDING DIV.
BETH STEEL CO. PLANNING	AMMUNITION SHIP AE 21
AE 21-11-25 SH2	BOOKLET OR GENERAL PLAN
23 JUNE 59	INBOARD & OUTBOARD PROFILES
DRAWN BY WLL	
CHECKED BY JER	
IN CHARGE CEM	
APPROVED CEM	
APPROVED CEM	
SELECTED RECORD PLAN	AE 21 50103 H1427927
	SCALE: 1/4" = 1' FOOT

27 JAN 1984





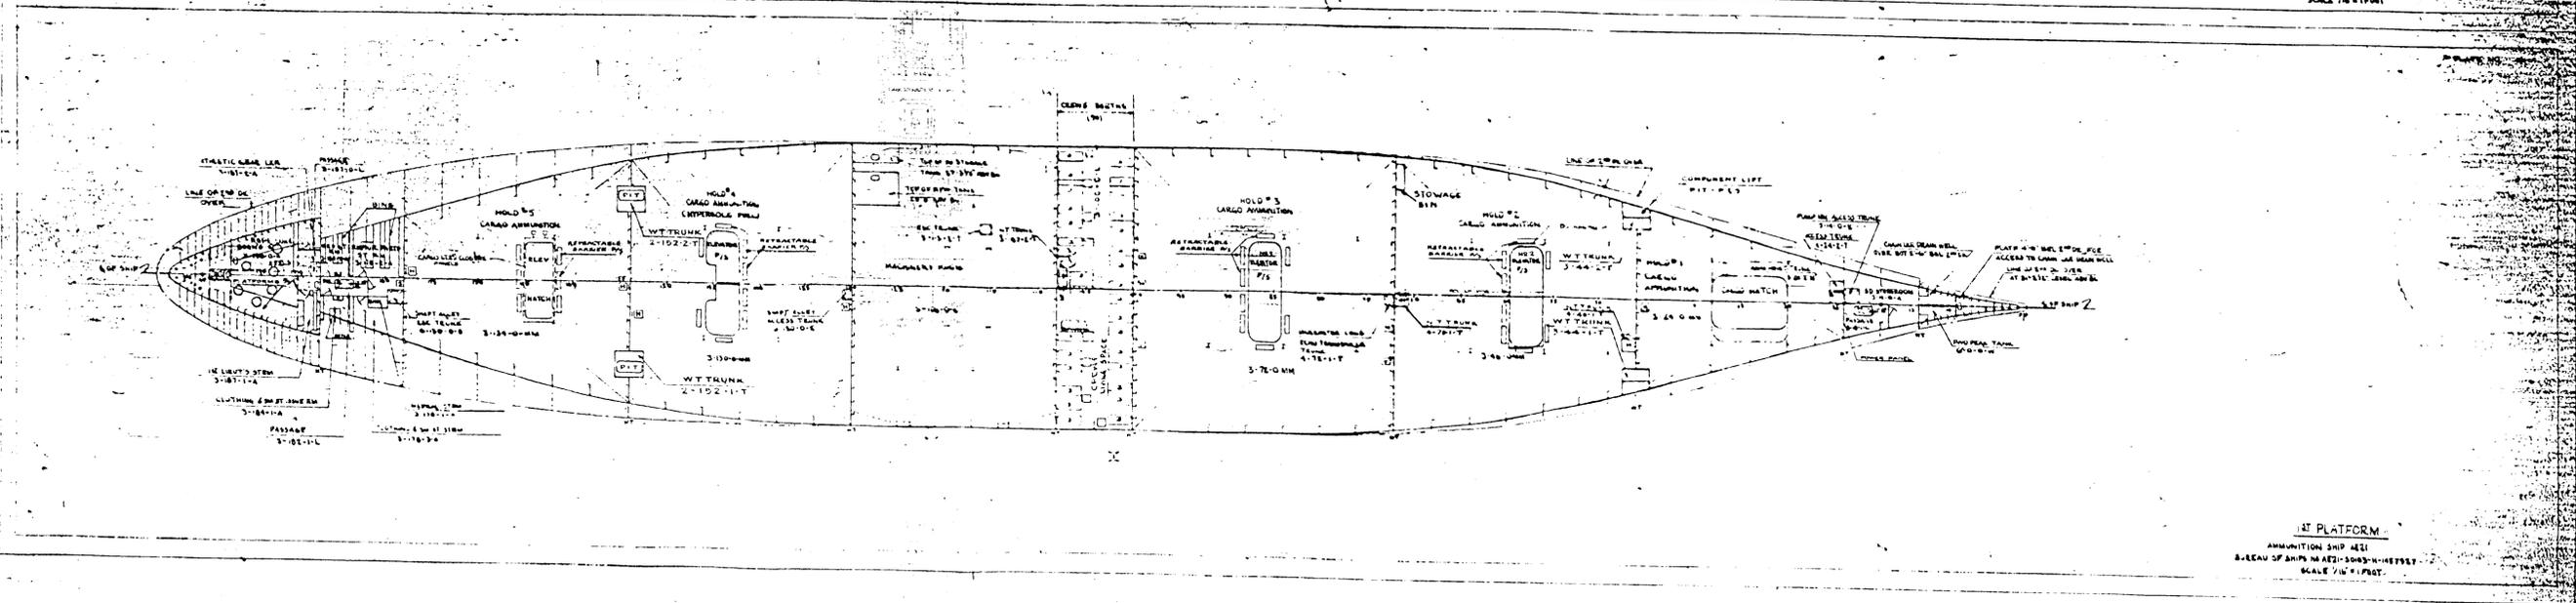



PLATE NO. 12

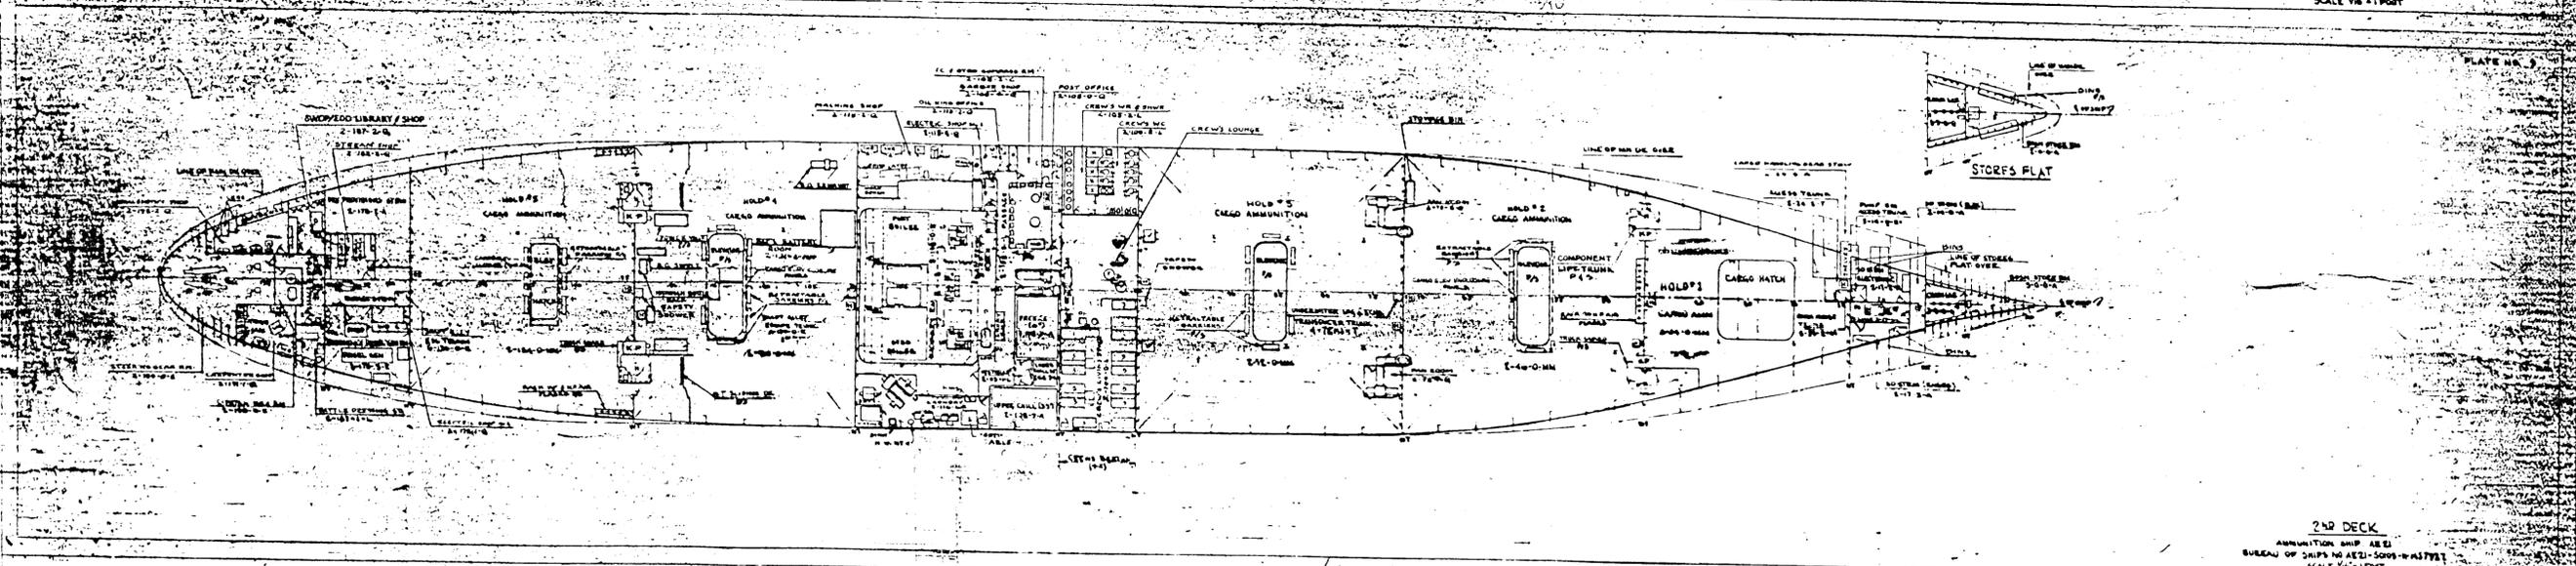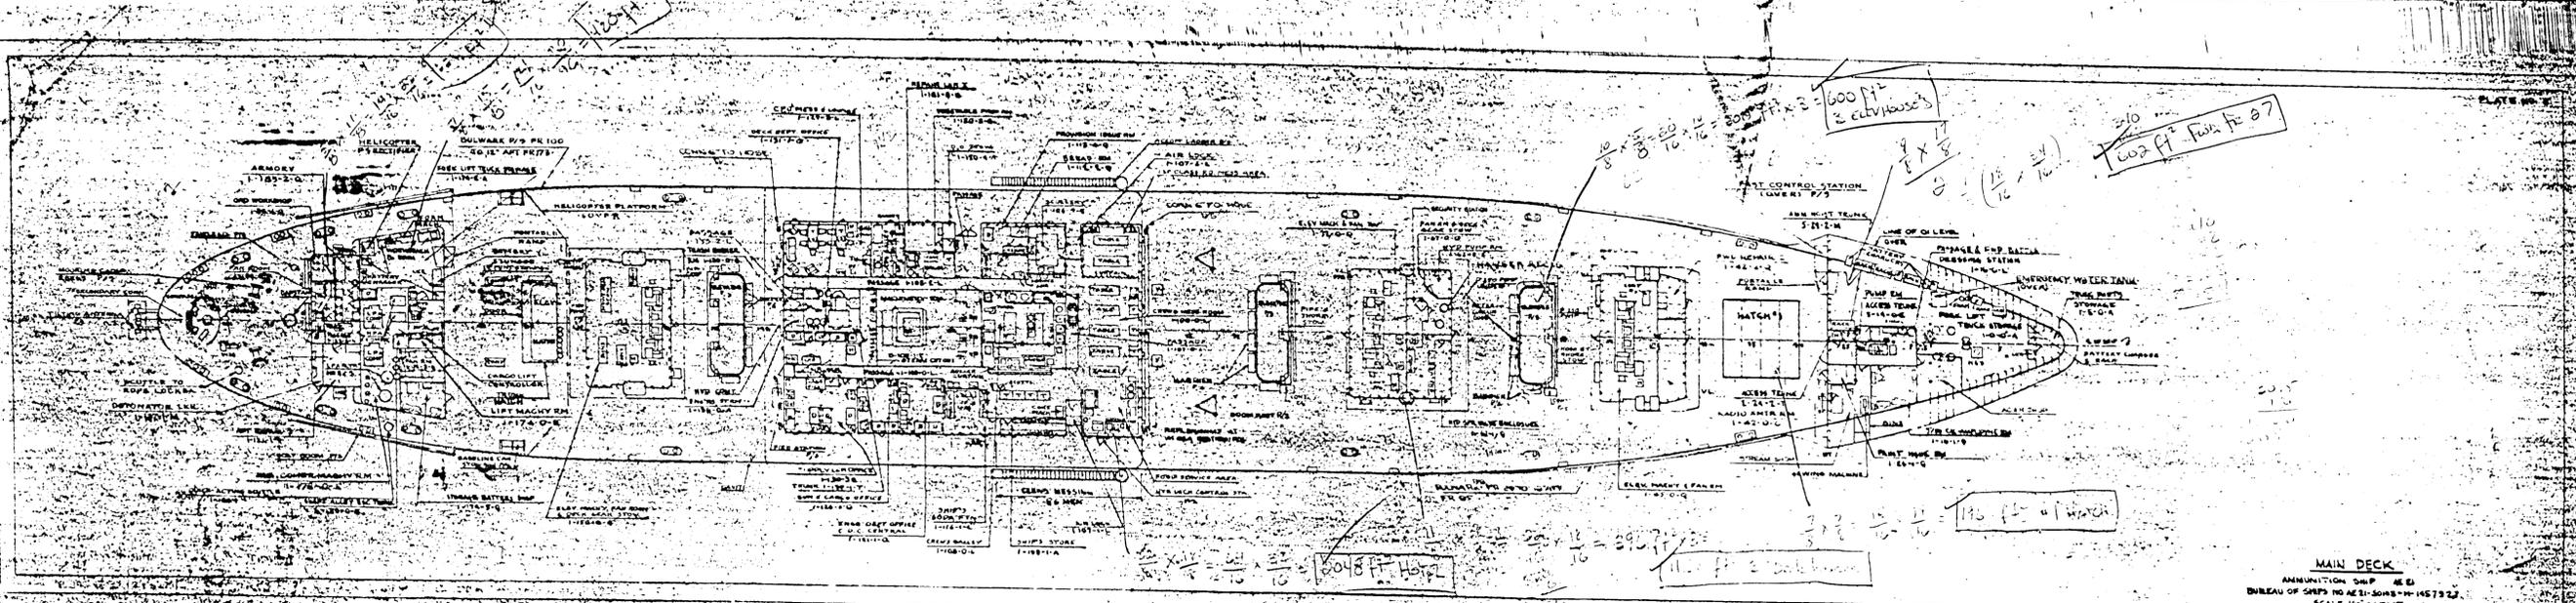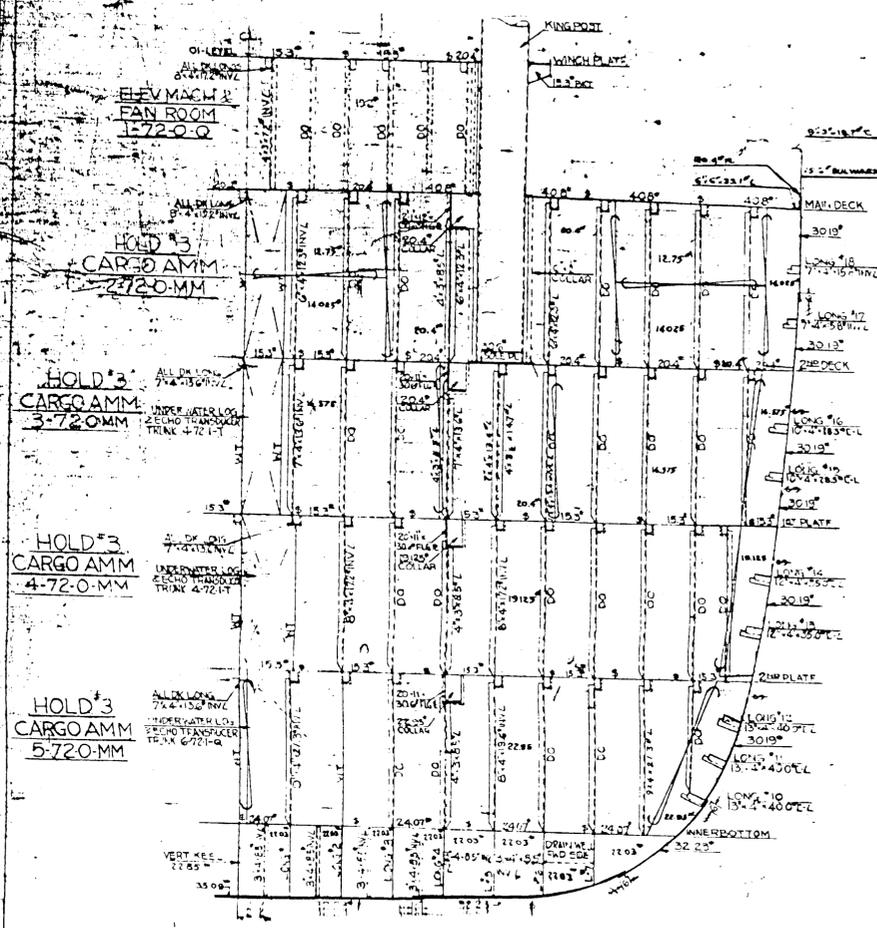


FRAME 72
SECTION LKG FWD

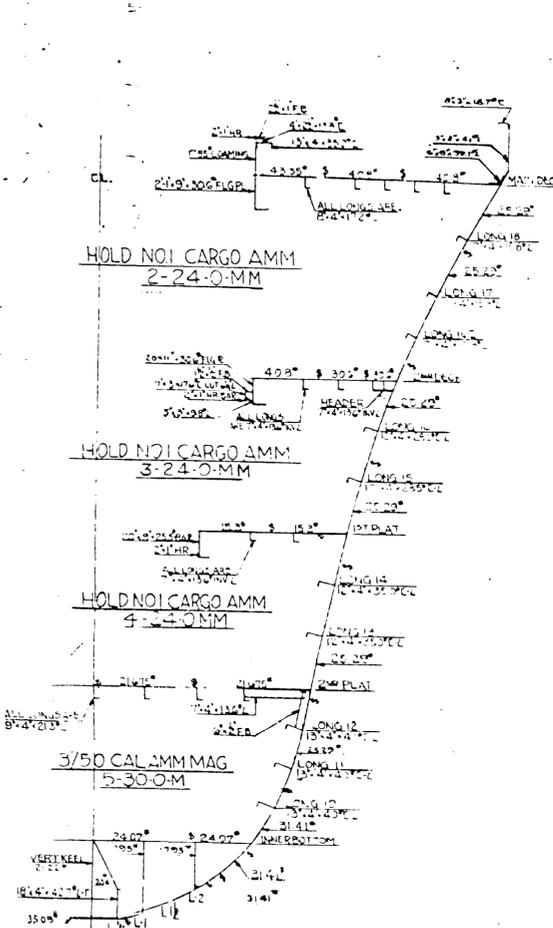

FRAME 35
SECTION LKG FWD

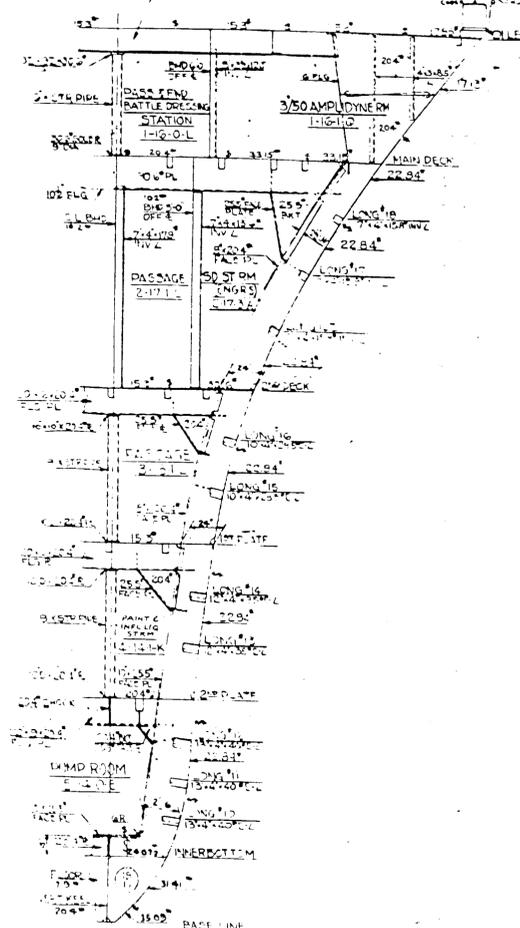

FRAME 19
SECTION LKG FWD

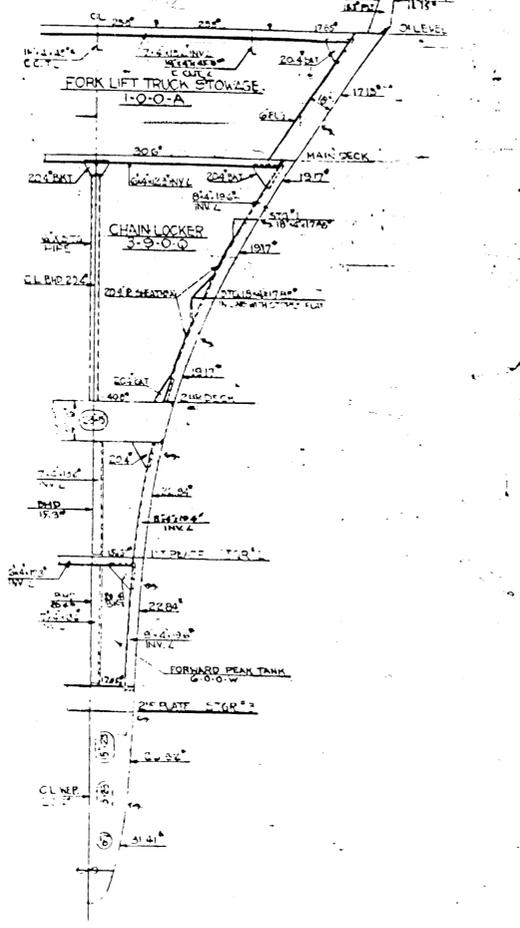

FRAME 11
SECTION LKG FWD

SECTIONS FWD
AMMUNITION SHIP AE 21
BUREAU OF SHIPS NO AE 21-5013-11657927
SCALE: 1/4" = 1'-0"

4540 AE 21 BETH	SPRINGS
BETH STL CO PLANNING	CONTRACTOR
AE 21-11-25 5H6	BETHLEHEM STEEL CO. SHIPBUILDING DIV.
DATE 23 JUN 47	QUINCY YARD
DRAWN BY WLR VDB	AMMUNITION SHIP AE 21
CHECKED BY ZS	BOOKLET OF GENERAL PLANS
IN CHARGE	SECTIONS FORWARD
APPROVED	APPROVED
APPROVED	APPROVED
SELECTED RECORD PLAN	AE 21 5013 11657927 I
	SCALE: 1/4" = 1'-0" SHEET 6 OF 7

